


**LEGEND**

CPS =	CRUISE PIER	SOUTH
CPN =	CRUISE PIER	NORTH
WJ =	WIND JAMMER	NORTH & WEST
CA =	CARGO-NORTH, MIDDLE, & SOUTH	
-NE =	NORTH EAST	
-NW =	NORTH WEST	
-SE =	SOUTH EAST	
-SW =	SOUTH WEST	

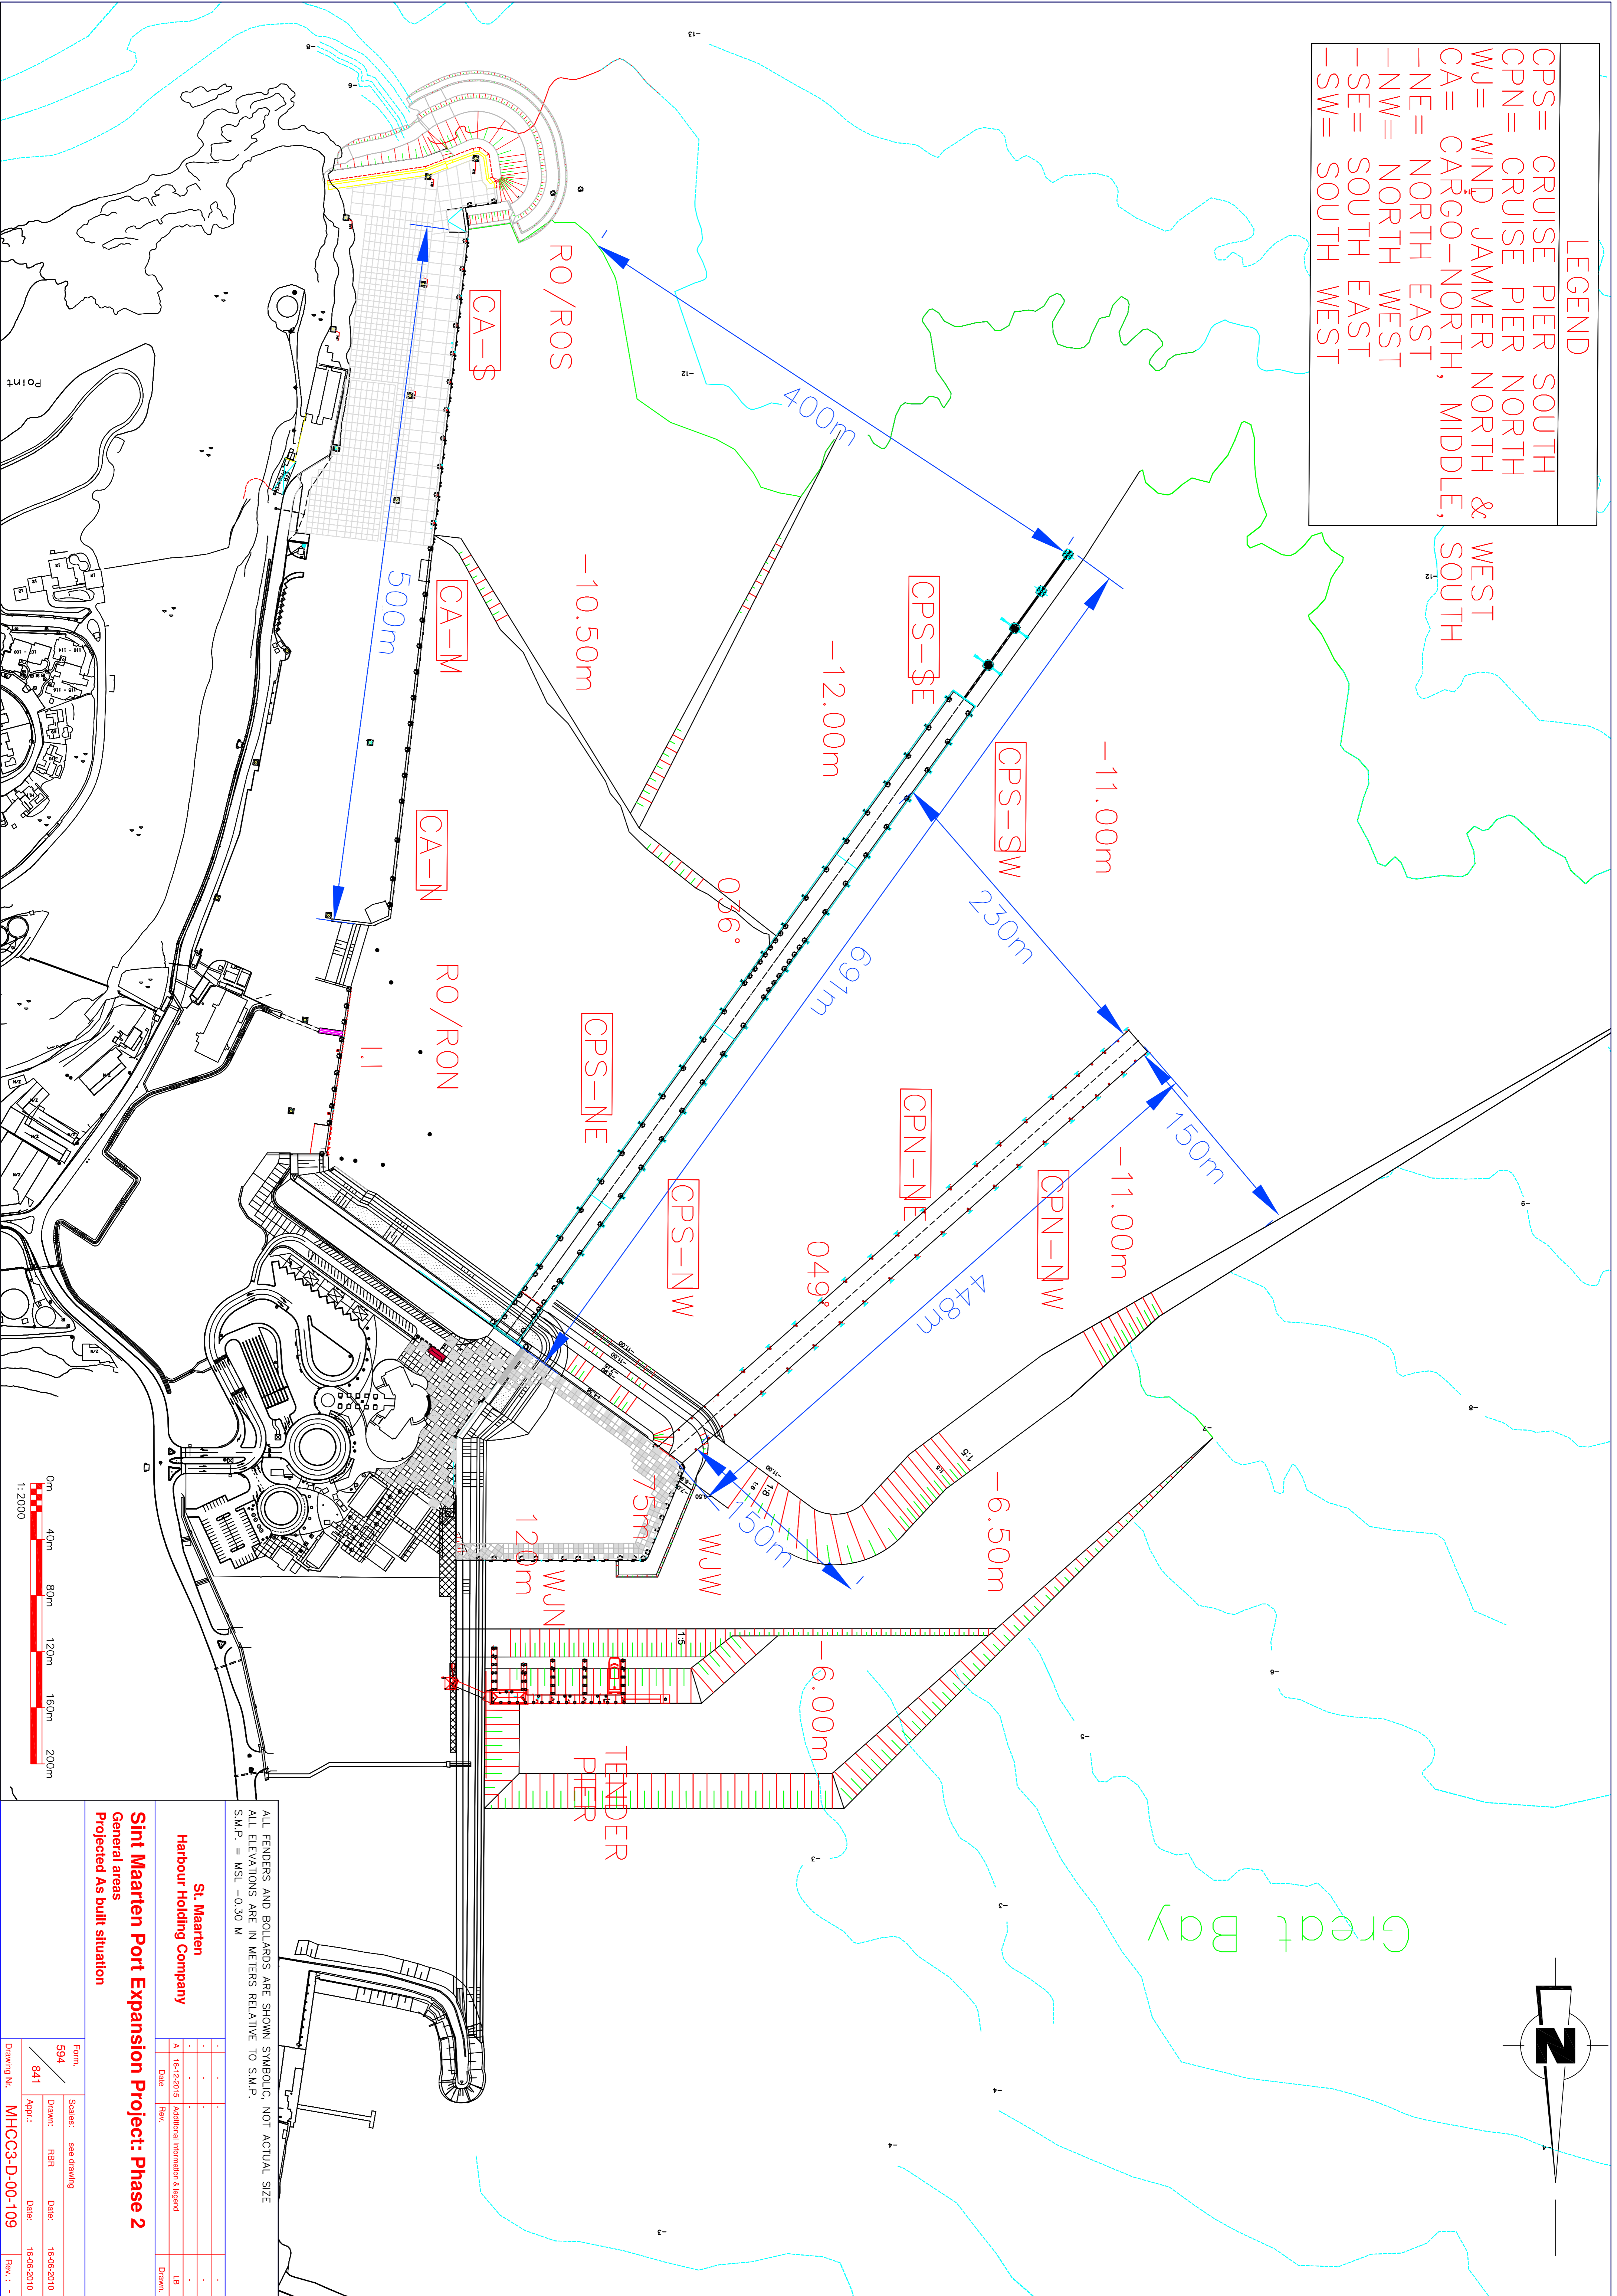

ALL FENDERS AND BOLLARDS ARE SHOWN SYMBOLIC, NOT ACTUAL SIZE  
 ALL ELEVATIONS ARE IN METERS RELATIVE TO S.M.P.  
 S.M.P. = MSL -0.30 M

**St. Maarten Harbour Holding Company**  
**Sint Maarten Port Expansion Project: Phase 2**  
 General areas  
 Projected As built situation

Form:	594	Scale:	see drawing	Date:	16-06-2010
Drawing No.:	841	Appr.:	RBR	Date:	16-06-2010
Rev.:		Drawn:	LB	Rev.:	